
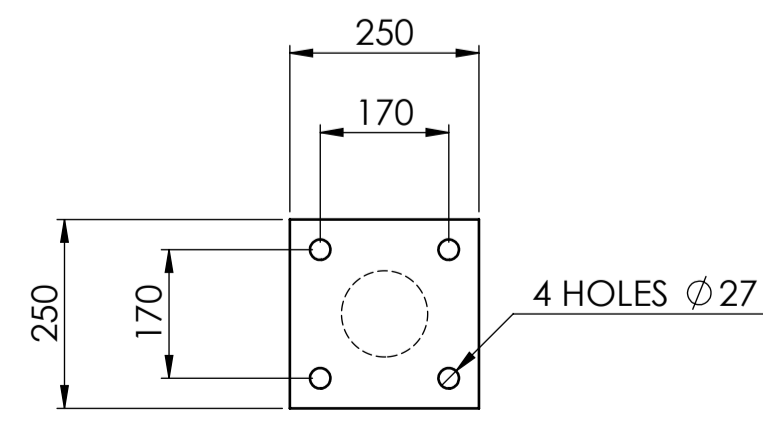
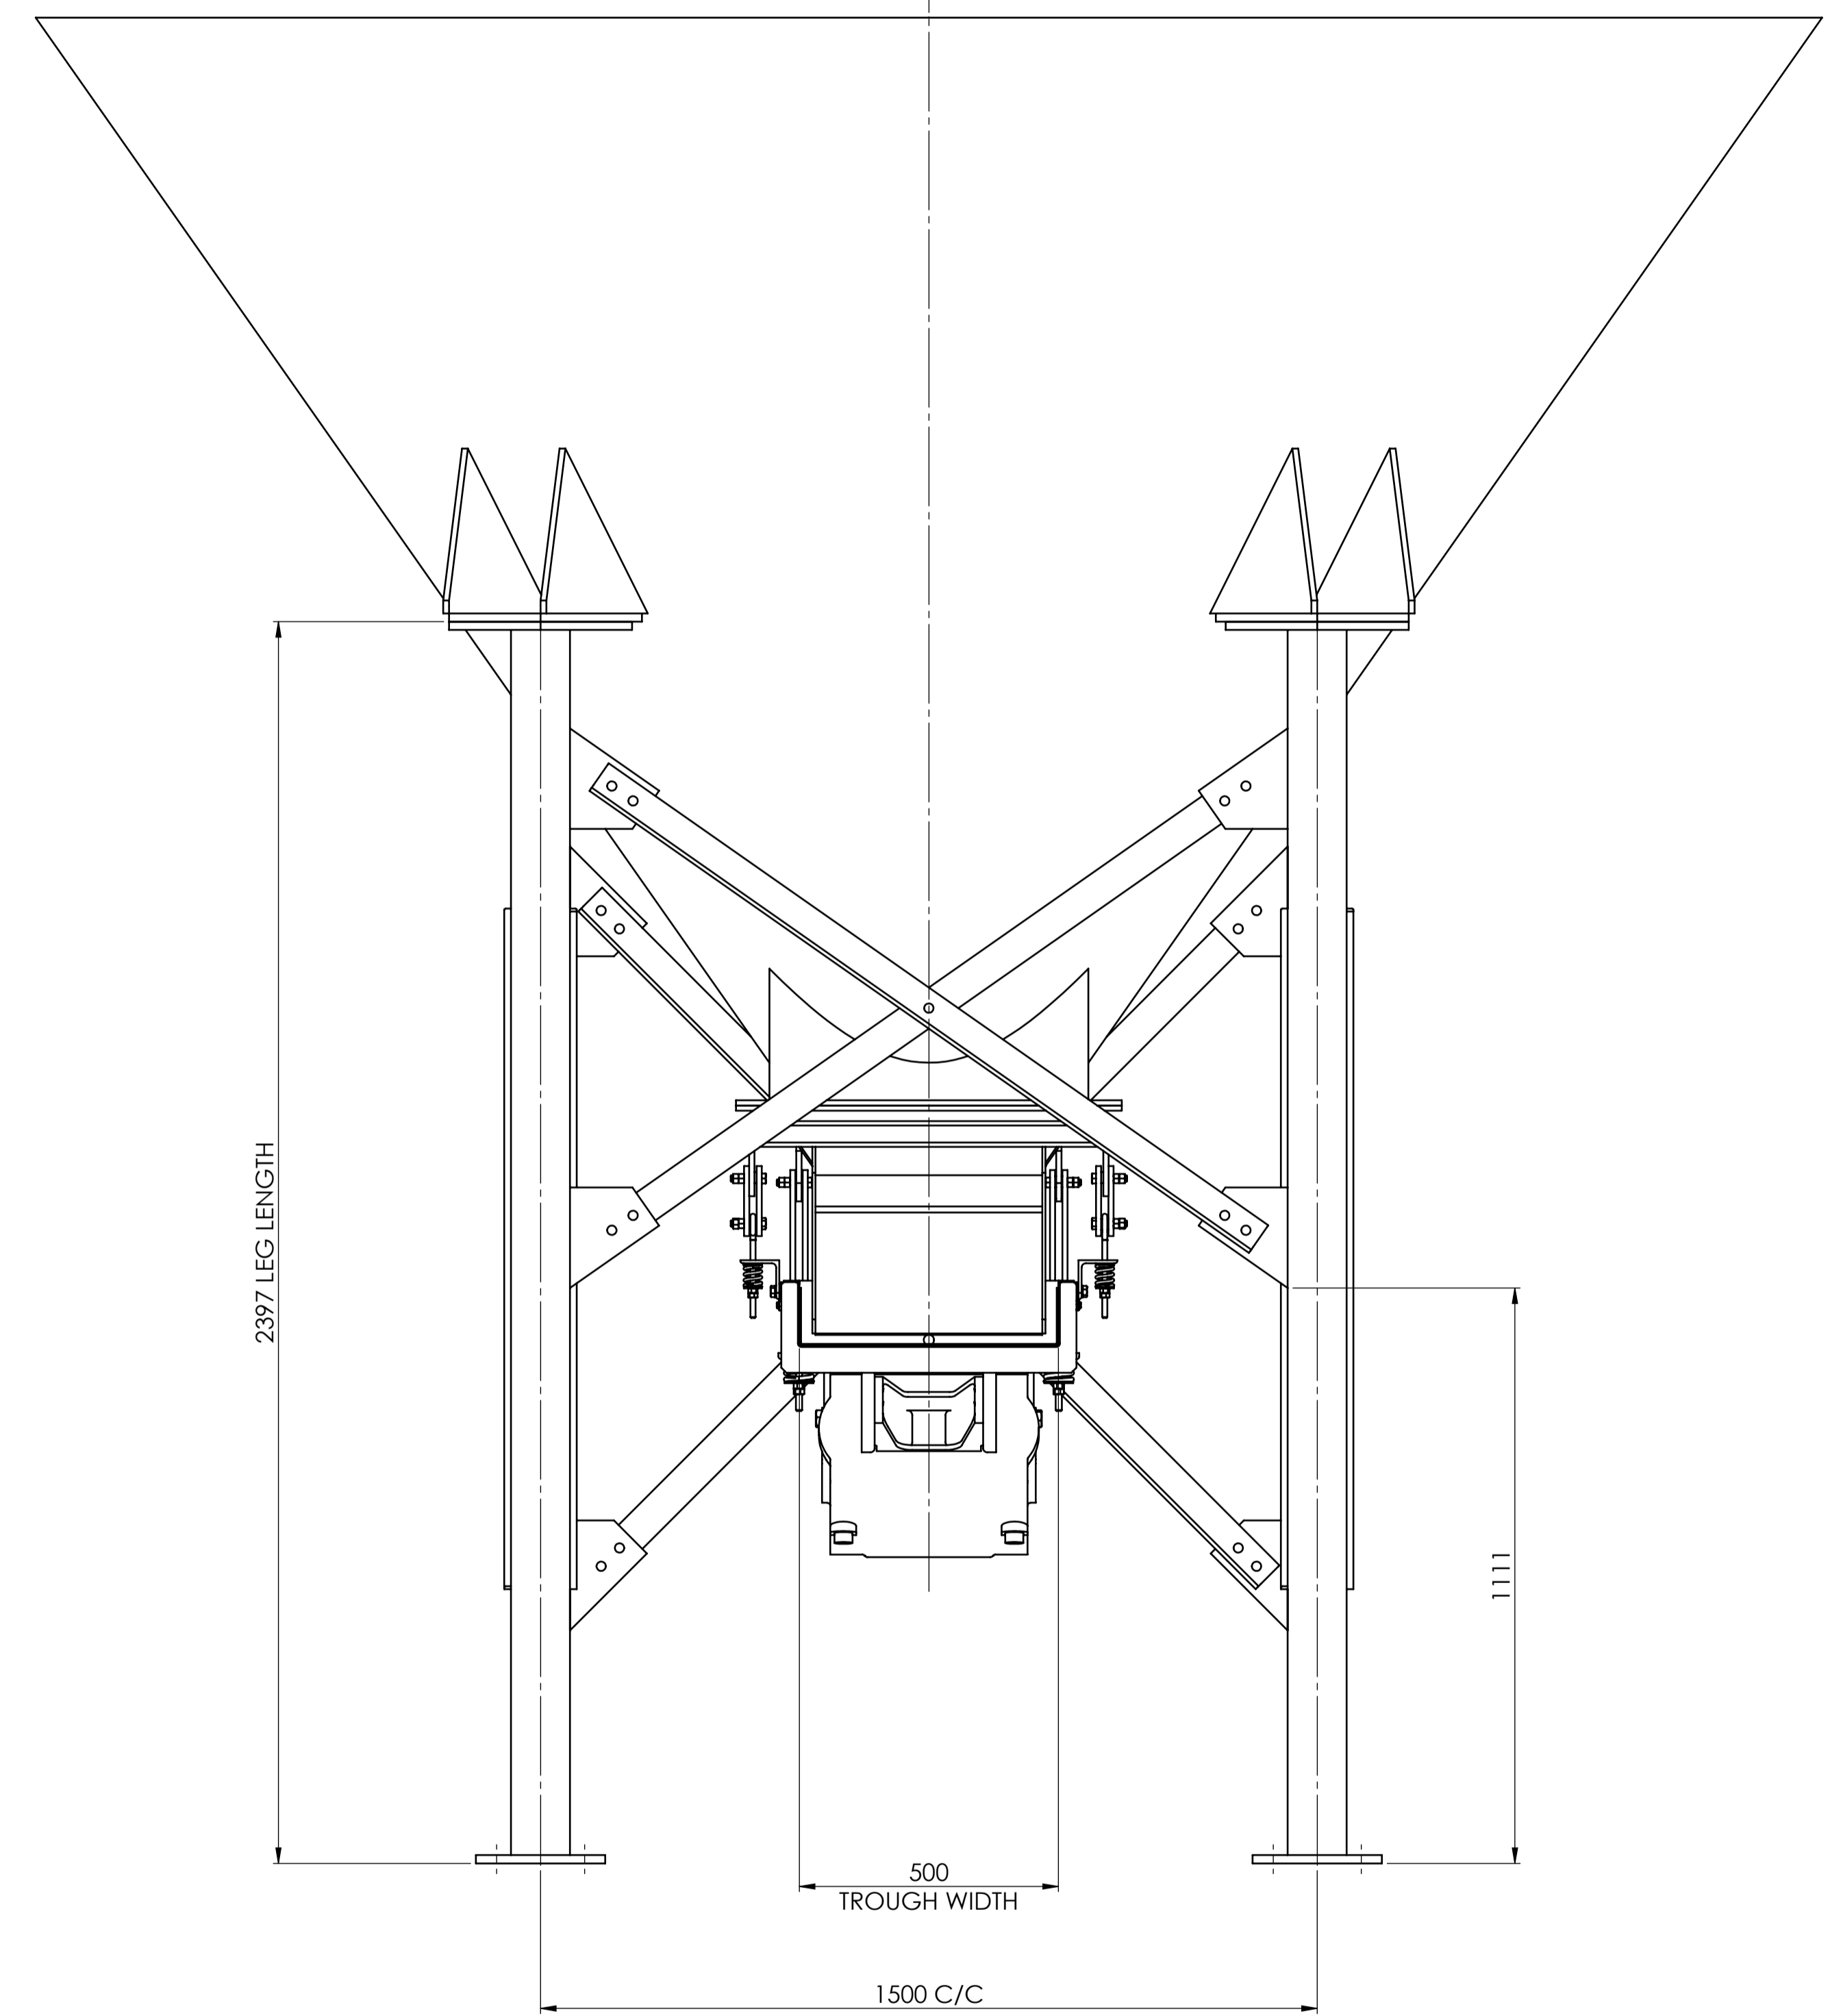


ITEM	PART No	DESCRIPTION	ITEM MASS	QTY.	MASS
1	BT-095	CONICAL HOPPER	2037.35	1	2037.3
2	081B1231	HOPPER	84.27	1	84.3
3	059B2857	FH22 FEEDER - 500w x 1000lg	228.00	1	228.0
4	056C2947V	SUSPENSION LINK PLATE ASSY	2.43	2	4.9
5	056C2947K	SUSPENSION LINK PLATE ASSY	1.26	2	2.5

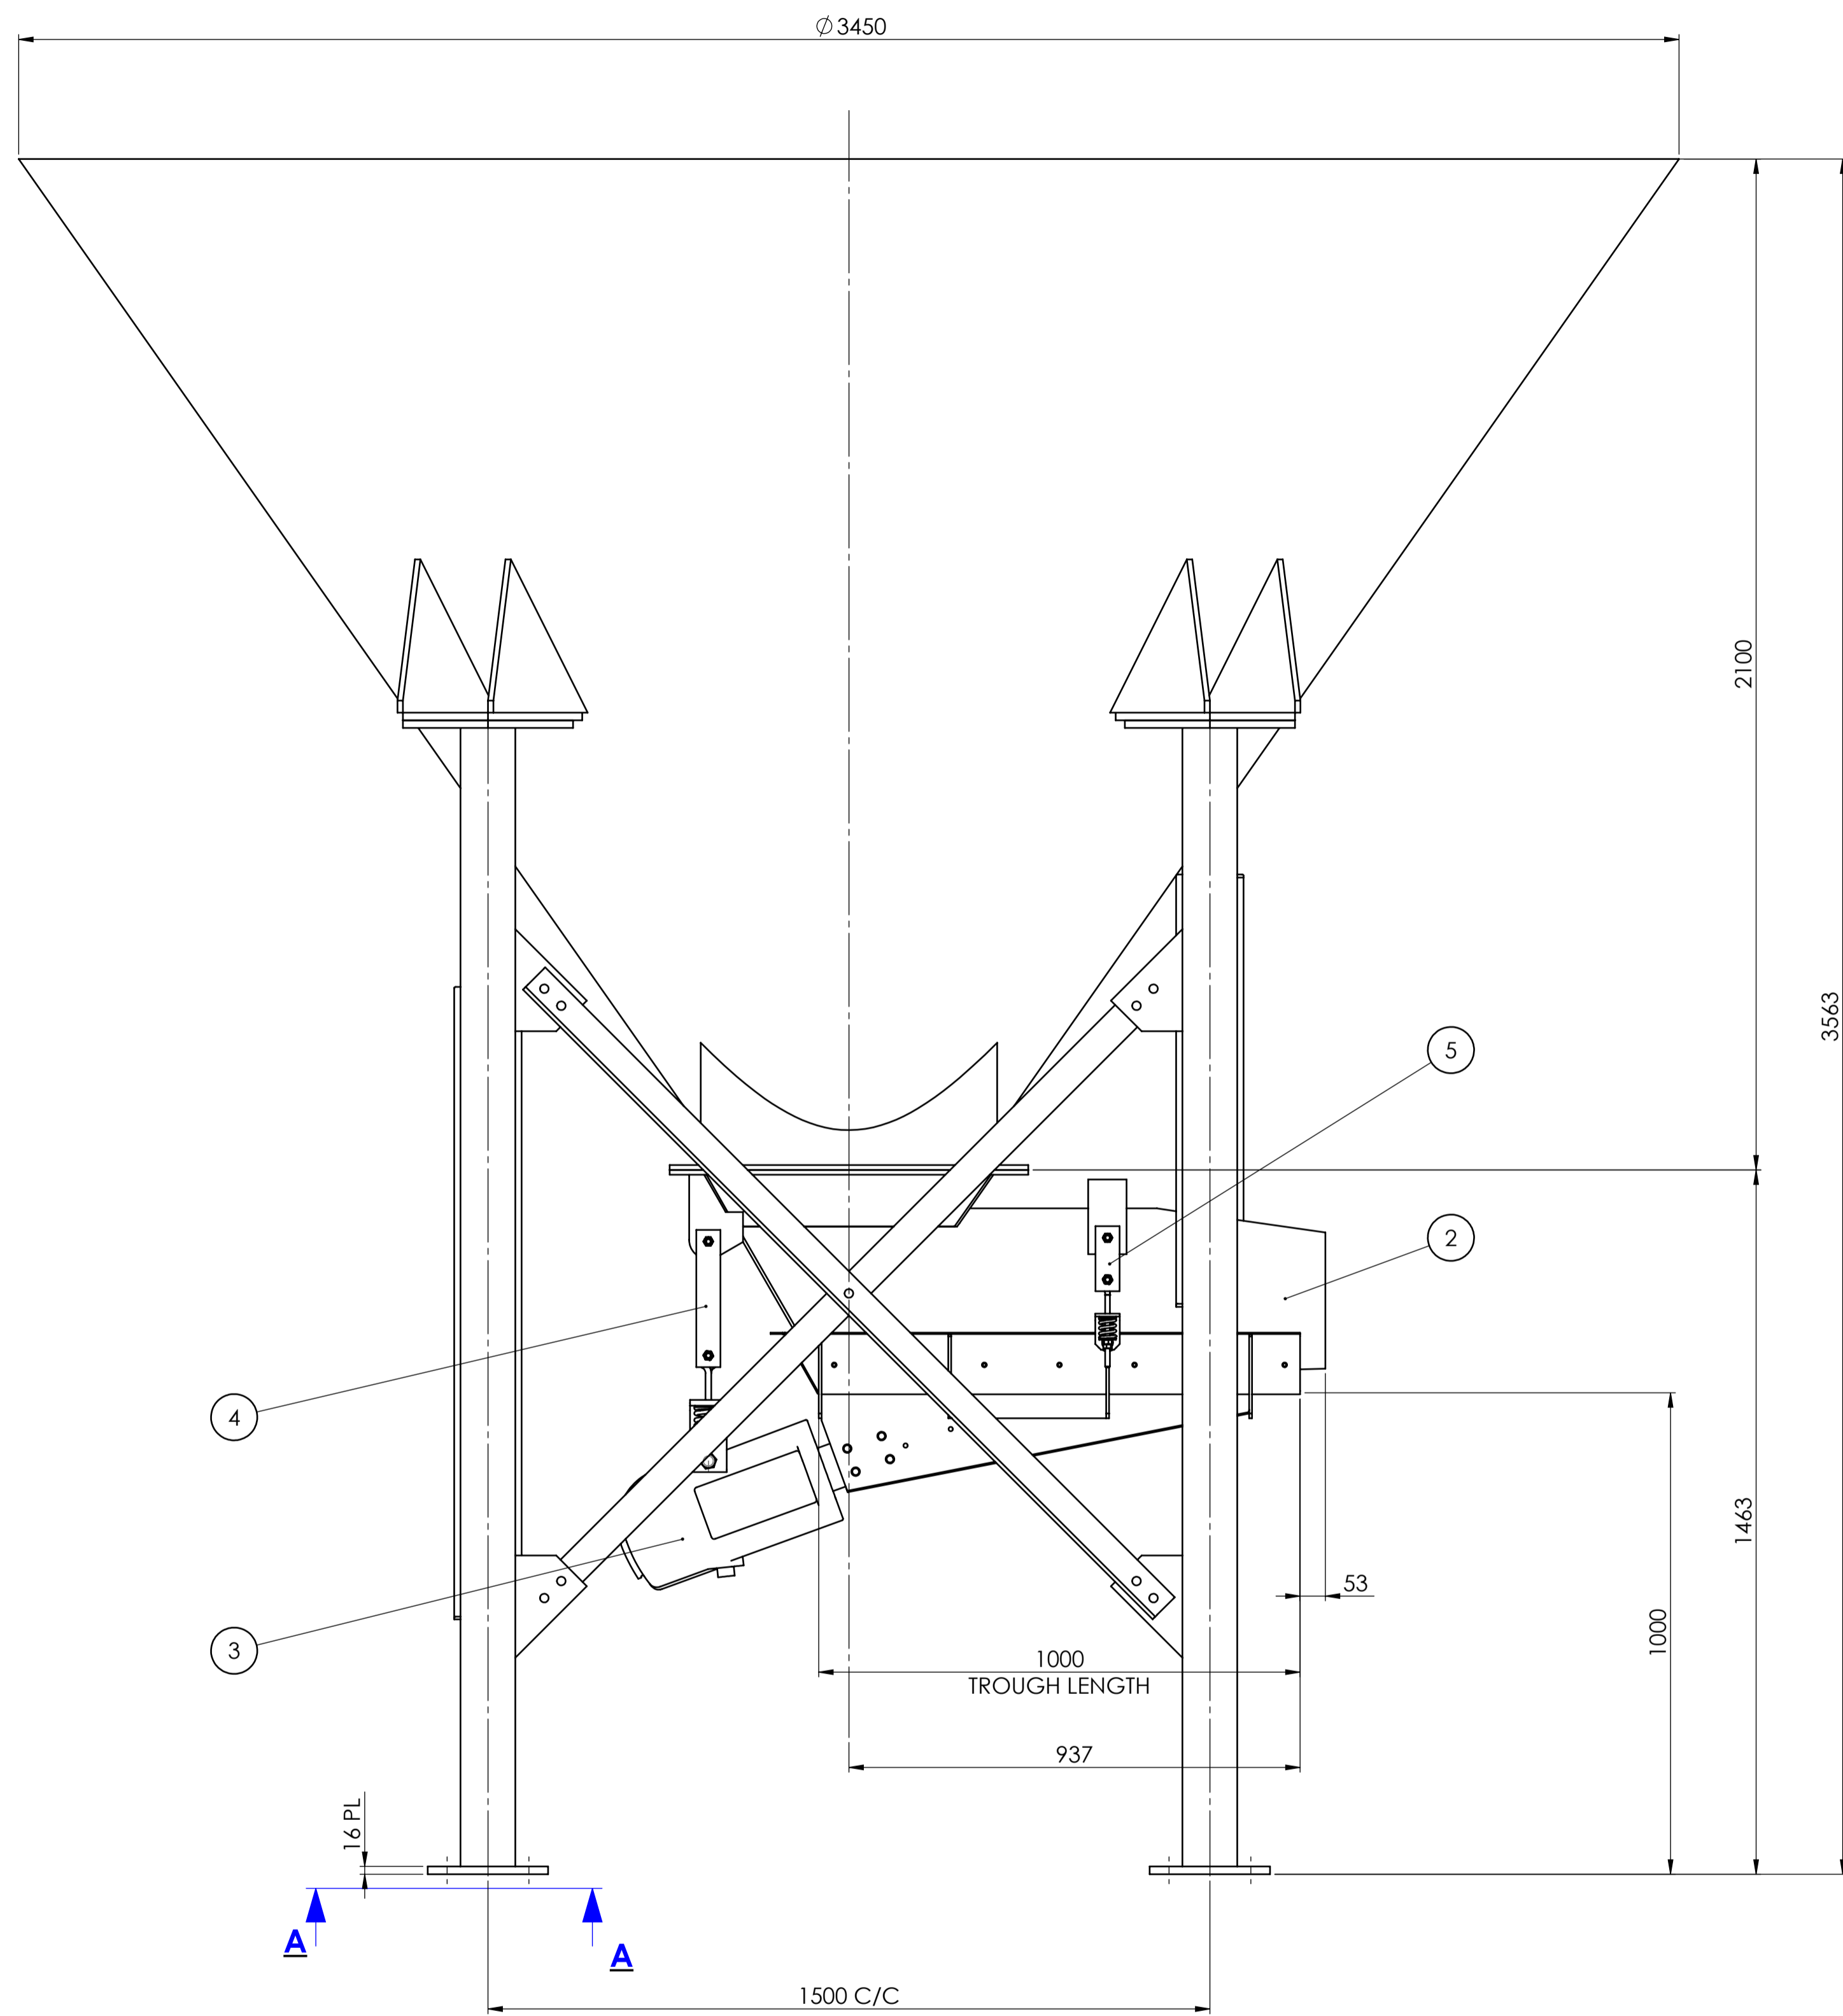

SECTION A-A

REV.	DESCRIPTION	DATE	BY
A	DRAWING CHECKED AND FINALISED	15/07/2020	
B	AS BUILT	9/10/2020	AGP

REFERENCE : S2000501
 OUTLINE :
 ALL DIMENSIONS IN MILLIMETRES

THIRD ANGLE PROJECTION
 MAIN SCALE 1:10

DRAWN A.PEARCE 15.07.20
 CHECKED
 DSGN REVIEW
 APPROVED

DRAWING No. 060B0773
 SHEET 1 OF 1

7.5 cu.m HOPPER WITH FH22 FEEDER ARRANGEMENT

REV. B